


EXHIBIT #10B

AS BUILT

# FLOOR PLAN

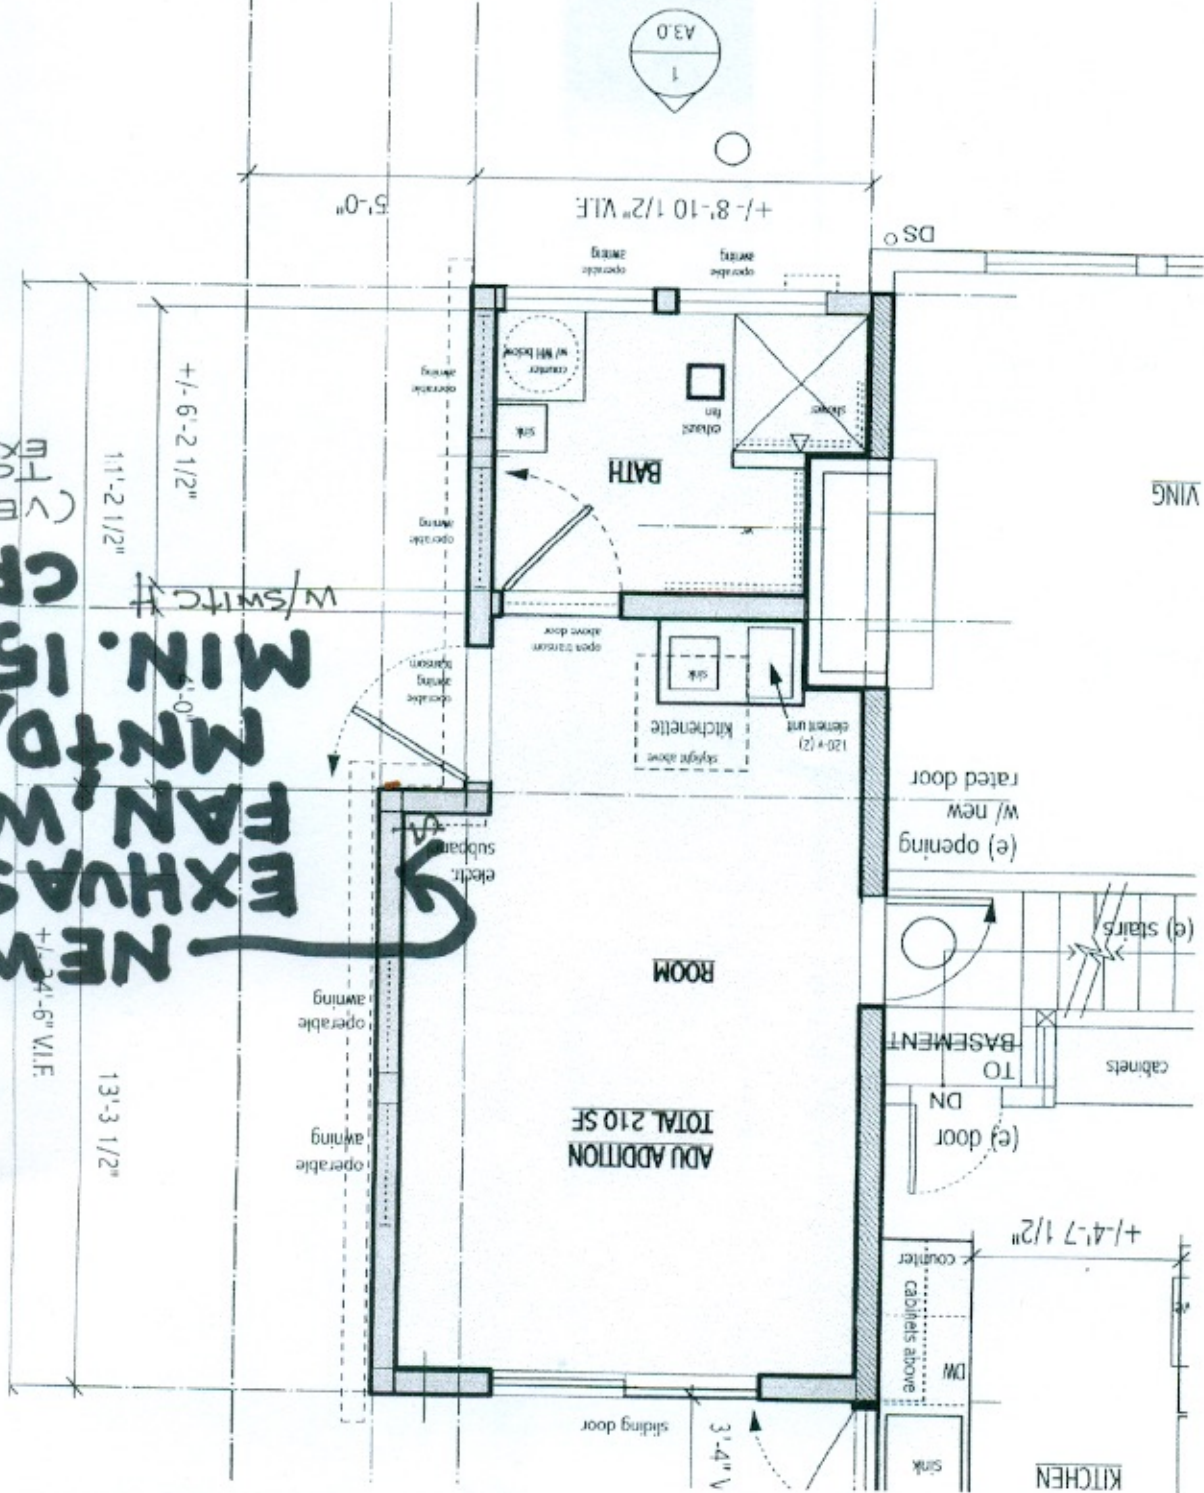

NEW EXHVAST FAN, WALL  
 MIN. 150 CFM (VENTS TO EXTERIOR)  
 W/SWITCH